

**LEGEND**

- STAGE BOUNDARY
- SUBSTAGE BOUNDARY
- - - - - FINISHED SURFACE CONTOURS (0.25m INTERVALS)
- 
- 
- ASL

**AS CONSTRUCTED CERTIFICATION**

THE WORK ON THIS DRAWING HAS BEEN CONSTRUCTED GENERALLY IN ACCORDANCE WITH THE DESIGN DRAWINGS AND THE INTENT OF THE GUIDELINES OF TOWNSVILLE CITY COUNCIL

APPROVED: *Chad Webb* RPEQ: 12732

for and on behalf of Empower Engineer & Project Managers

AS CONSTRUCTED

I, RYAN MACHIN OF SURVEYING SOLUTIONS AUSTRALIA, HEREBY CERTIFY THAT THE WORKS AS SHOWN ON THE AS CONSTRUCTED DRAWINGS REFLECT ANY CHANGES THAT WERE MADE DURING THE COURSE OF CONSTRUCTION.


*Ryan Machin* DATE: 29.03.2023

RYAN MACHIN SQ No. 6700

ABN: 78 632 363 916 M: (08) 428 258 917

49 Gaiocochea Drive Bushland Beach, QLD, 4818

Accepted As Constructed

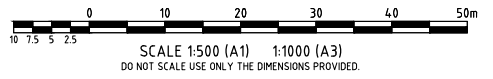

**NOTE:**  
THIS AS CONSTRUCTED CERTIFICATION IS RELEVANT TO STAGE 13C ONLY.

AS CONSTRUCTED

*Chad Webb*  
Registered Engineer  
29/3/2023  
Date Register  
12732  
ENGINEERING CERTIFICATION



Client: **URBEX PTY LTD**  
Project: **THE RESERVE - STAGE 13C**  
Title: **EARTHWORKS LAYOUT PLAN**

Datum: **AHD PSM 200645 RL 14.410 (MGA) COORD**

AS CONSTRUCTED

Project No. Drawing No. Rev  
**B00393-CE300 0**

User: WILLIAM GRIFFITH File Name: C:\Users\william\Documents\113314\_Civil\_DWG\14.410\_A3\_CON\3\_Stage\_EA\B00393-ASCON-CEWKS Date: 27/03/2023 4:42:13 PM

This drawing cannot be copied or reproduced in any form or used for any purpose other than that originally intended without the written permission of Empower Engineers and Project Managers ©COPYRIGHT 2022