


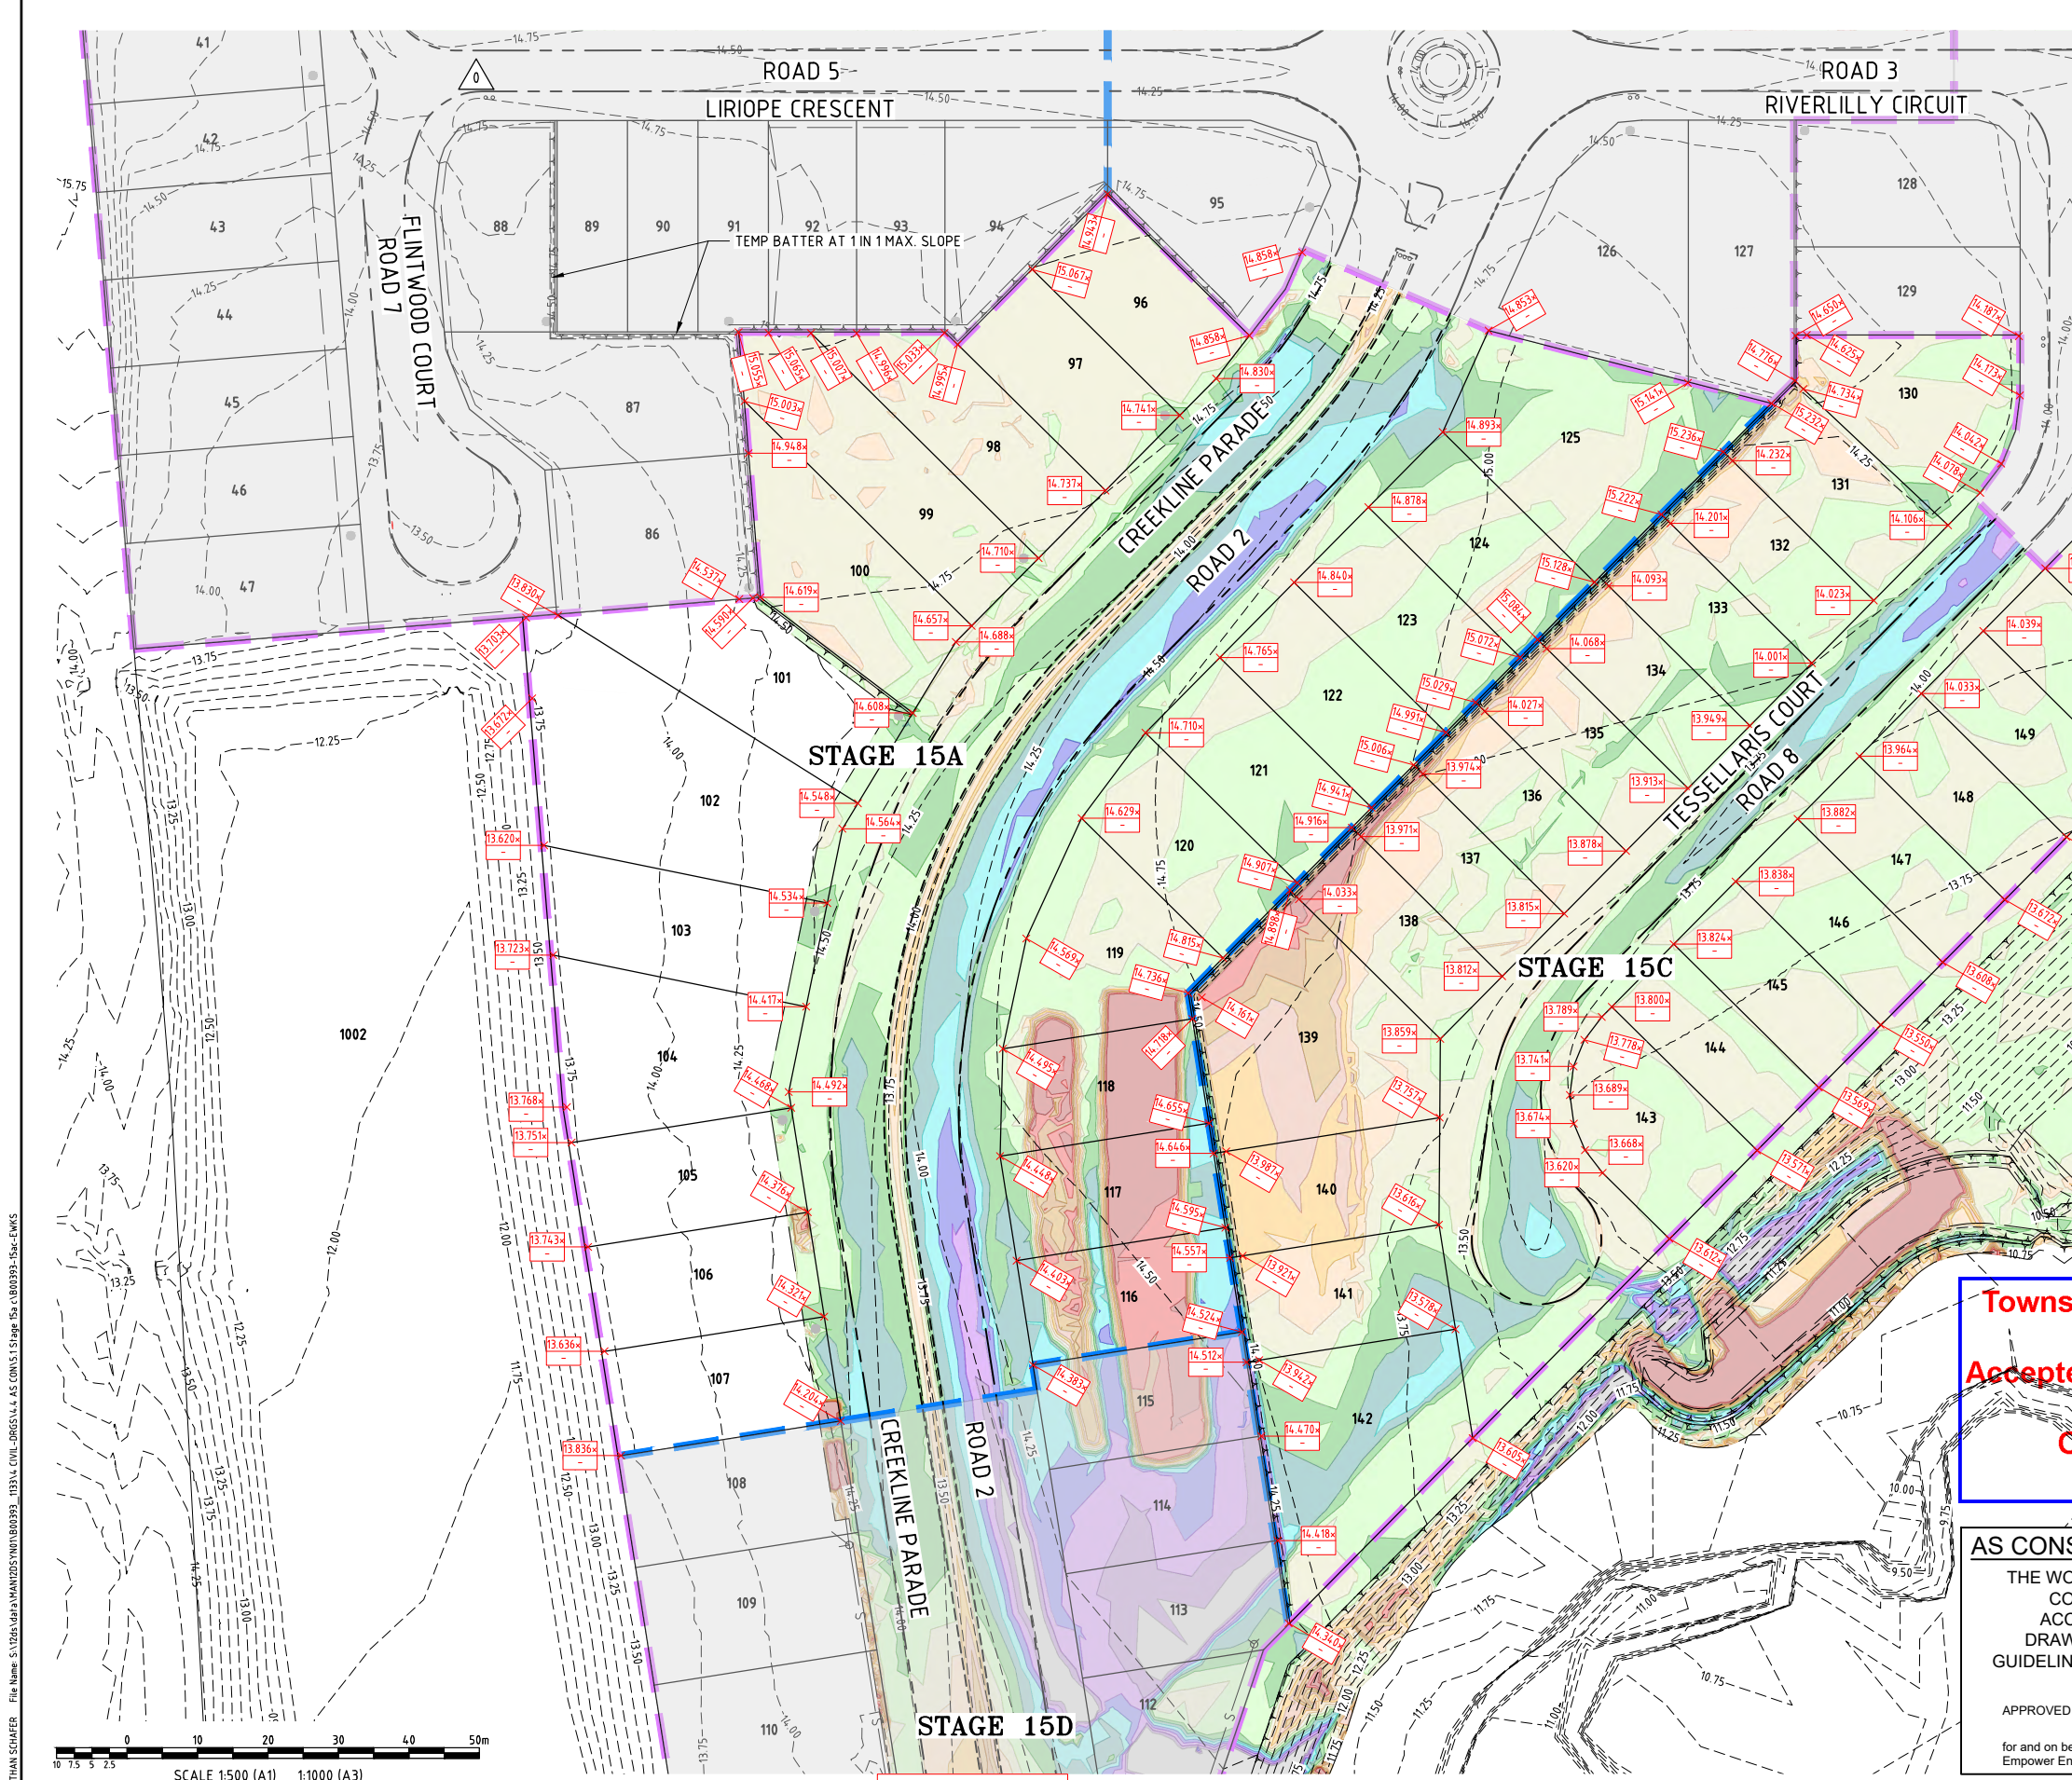

- LEGEND**
- STAGE BOUNDARY
 - SUBSTAGE BOUNDARY
 - FINISHED SURFACE CONTOURS (0.25m INTERVALS)
 - LOT BOUNDARY
 - TOP OF BATTER
 - BARRIER TYPE KERB AND CHANNEL
 - MOUNTABLE TYPE KERB AND CHANNEL
 - F.S.L. = FINISHED SURFACE LEVEL
+ = DEPTH OF FILL
- = DEPTH OF CUT

EARTHWORKS DEPTH RANGE
(0.10m INTERVALS)

FILL 0.70m +	CUT 0.00m - 0.10m
FILL 0.60m - 0.70m	CUT 0.10m - 0.20m
FILL 0.50m - 0.60m	CUT 0.20m - 0.30m
FILL 0.40m - 0.50m	CUT 0.30m - 0.40m
FILL 0.30m - 0.40m	CUT 0.40m - 0.50m
FILL 0.20m - 0.30m	CUT 0.50m - 0.60m
FILL 0.10m - 0.20m	CUT 0.60m - 0.70m
FILL 0.00m - 0.10m	CUT 0.70m +

NOTES:
REFER TO DRAWING NUMBER B00393-CE600 FOR EARTHWORKS NOTES AND DETAILS.

Townsville City Council
Accepted As Constructed
OPW21/0024
29/09/2025

AS CONSTRUCTED CERTIFICATION
THE WORK ON THIS DRAWING HAS BEEN CONSTRUCTED GENERALLY IN ACCORDANCE WITH THE DESIGN DRAWINGS AND THE INTENT OF THE GUIDELINES OF TOWNSVILLE CITY COUNCIL
APPROVED: [Signature] RPEQ: 12732
for and on behalf of Empower Engineer & Project Managers

LEVEL UP SURVEYING PTY LTD (ABN 74 682 454 717), 7/53 DACMAR ROAD, COOLUMB BEACH QLD 4573 hereby certify that this Drawing accurately and correctly describes and records the nature and location of the works depicted by asterisks (*) herein as they have been constructed for subdivision.
Name: Brad Costello
Registration No. 7430
Signature: [Signature]
Date: 23/09/25
NOTE:
THIS AS CONSTRUCTED CERTIFICATION IS RELEVANT TO STAGE 15A AND STAGE 15C ONLY.

0	AS CONSTRUCTED	LS	LW	CH	CH	09/09/25
No.	Amendments	Drawn	Design	Design	Chk	Appd
This drawing cannot be copied or reproduced in any form or used for any purpose other than that originally intended without the written permission of Empower Engineers and Project Managers ©COPYRIGHT 2025						

AS CONSTRUCTED
[Signature]
Registered Engineer 12732
Date 25/9/2025
Register
ENGINEERING CERTIFICATION
THE Reserve
From the developers of Kalynda Chase
urbex designed for life

EMPOWER

Client	URBEX PTY LTD	Datum	AHD
Project	THE RESERVE - STAGE 15A AND 15C	PSM	200645
Title	EARTHWORKS LAYOUT PLAN SHEET 1 OF 2	RL	14.410
		(MGA) COORD	
		Project No.	B00393-CE601
		Drawing No.	
		Rev	0